


P:\PROJECTS\2531 SLS\Arch\2531A101-01.dwg, 4/30/2004 1:11:01 PM, mbernard, Acrobat PDFWriter, Letter [8.5 x 11 in]

**WARRENSTREET ARCHITECTS**  
27 Warren Street Concord NH 03301  
T 603.225.0640 F 603.225.0621 www.warrenstreetarch.com

CONSULTANTS / KEY PLAN

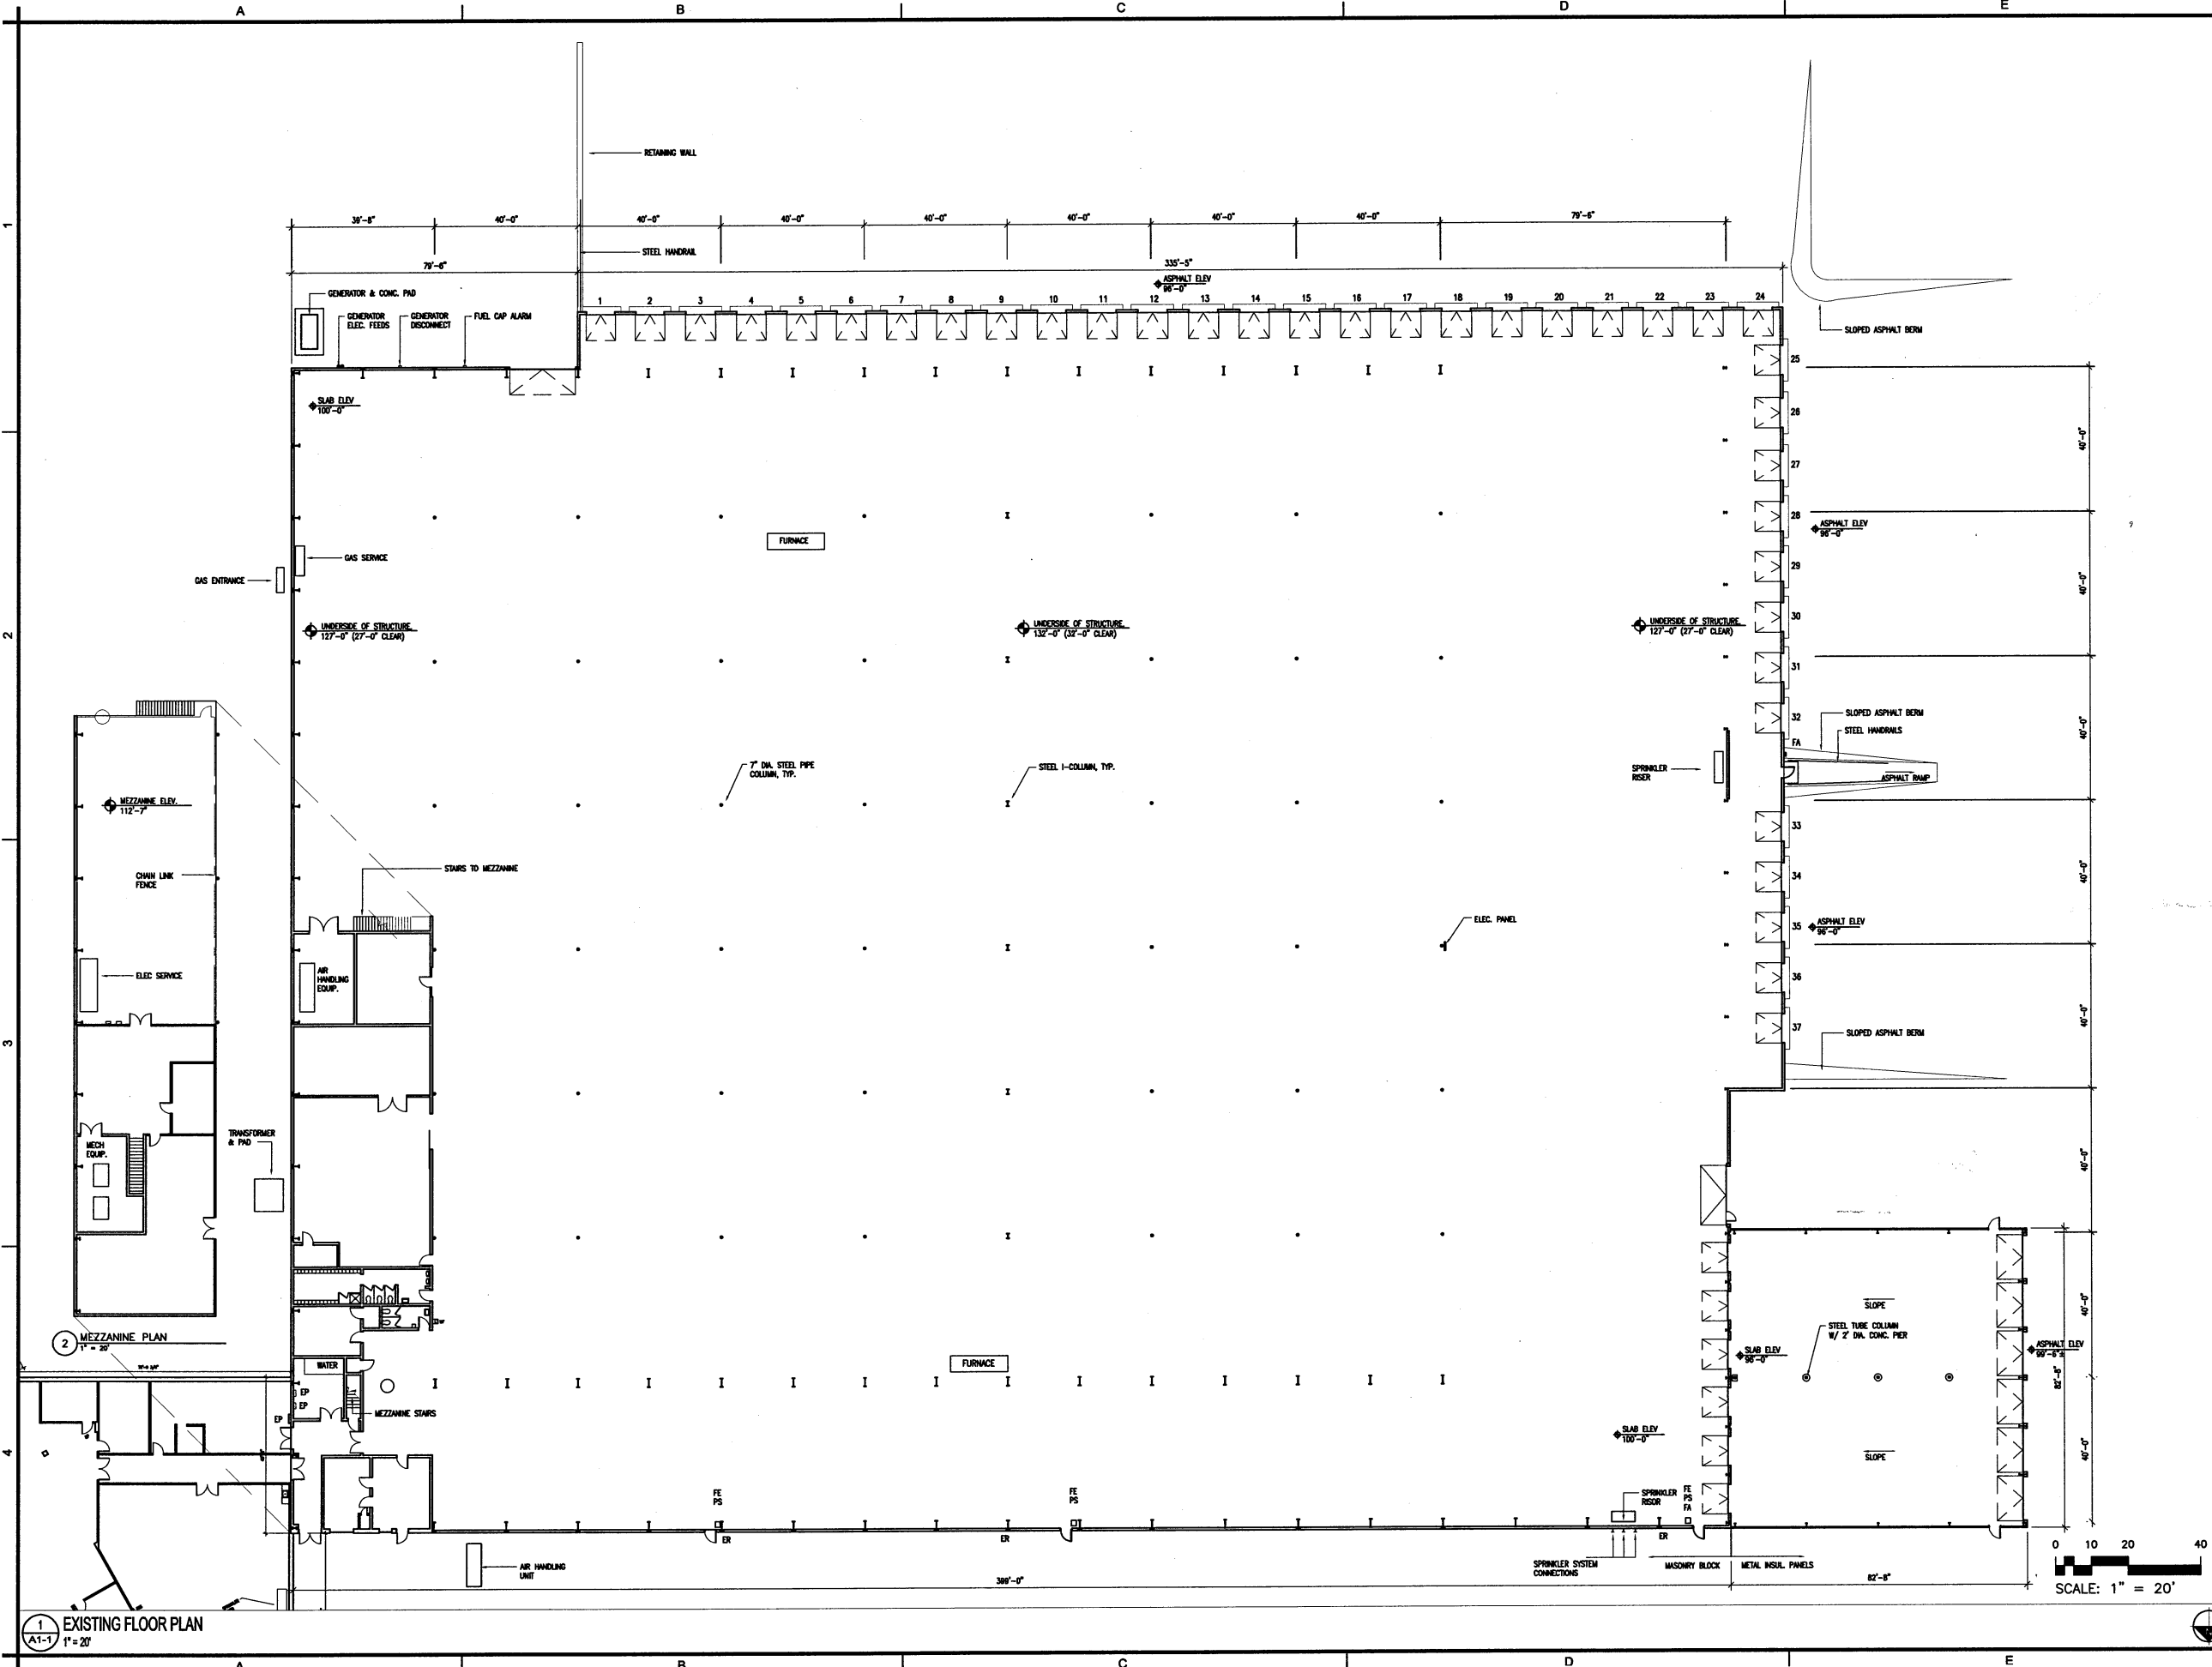

PROJECT TITLE / ADDRESS

266 ROUTE 125  
KINGSTON, NH

SCALE: AS NOTED DWG: 2527A1-01  
JOB #: 252827 XREF: 2528REFP  
DWN BY: MRB CND BY: JH  
04/30/04


EXISTING CONDITIONS  
NOT FOR CONSTRUCTION  
REVISIONS

EXISTING  
CONDITIONS  
DOCUMENTATION

**A1-3**

SHEET NUMBER OF  
Copyright Warrenstreet Architects © 2004

P:\PROJECTS\2531 SLS\Arch\2531A01-01.dwg, 4/30/2004 1:10:36 PM, mbernard, Acrobat PDFWriter, Custom page size

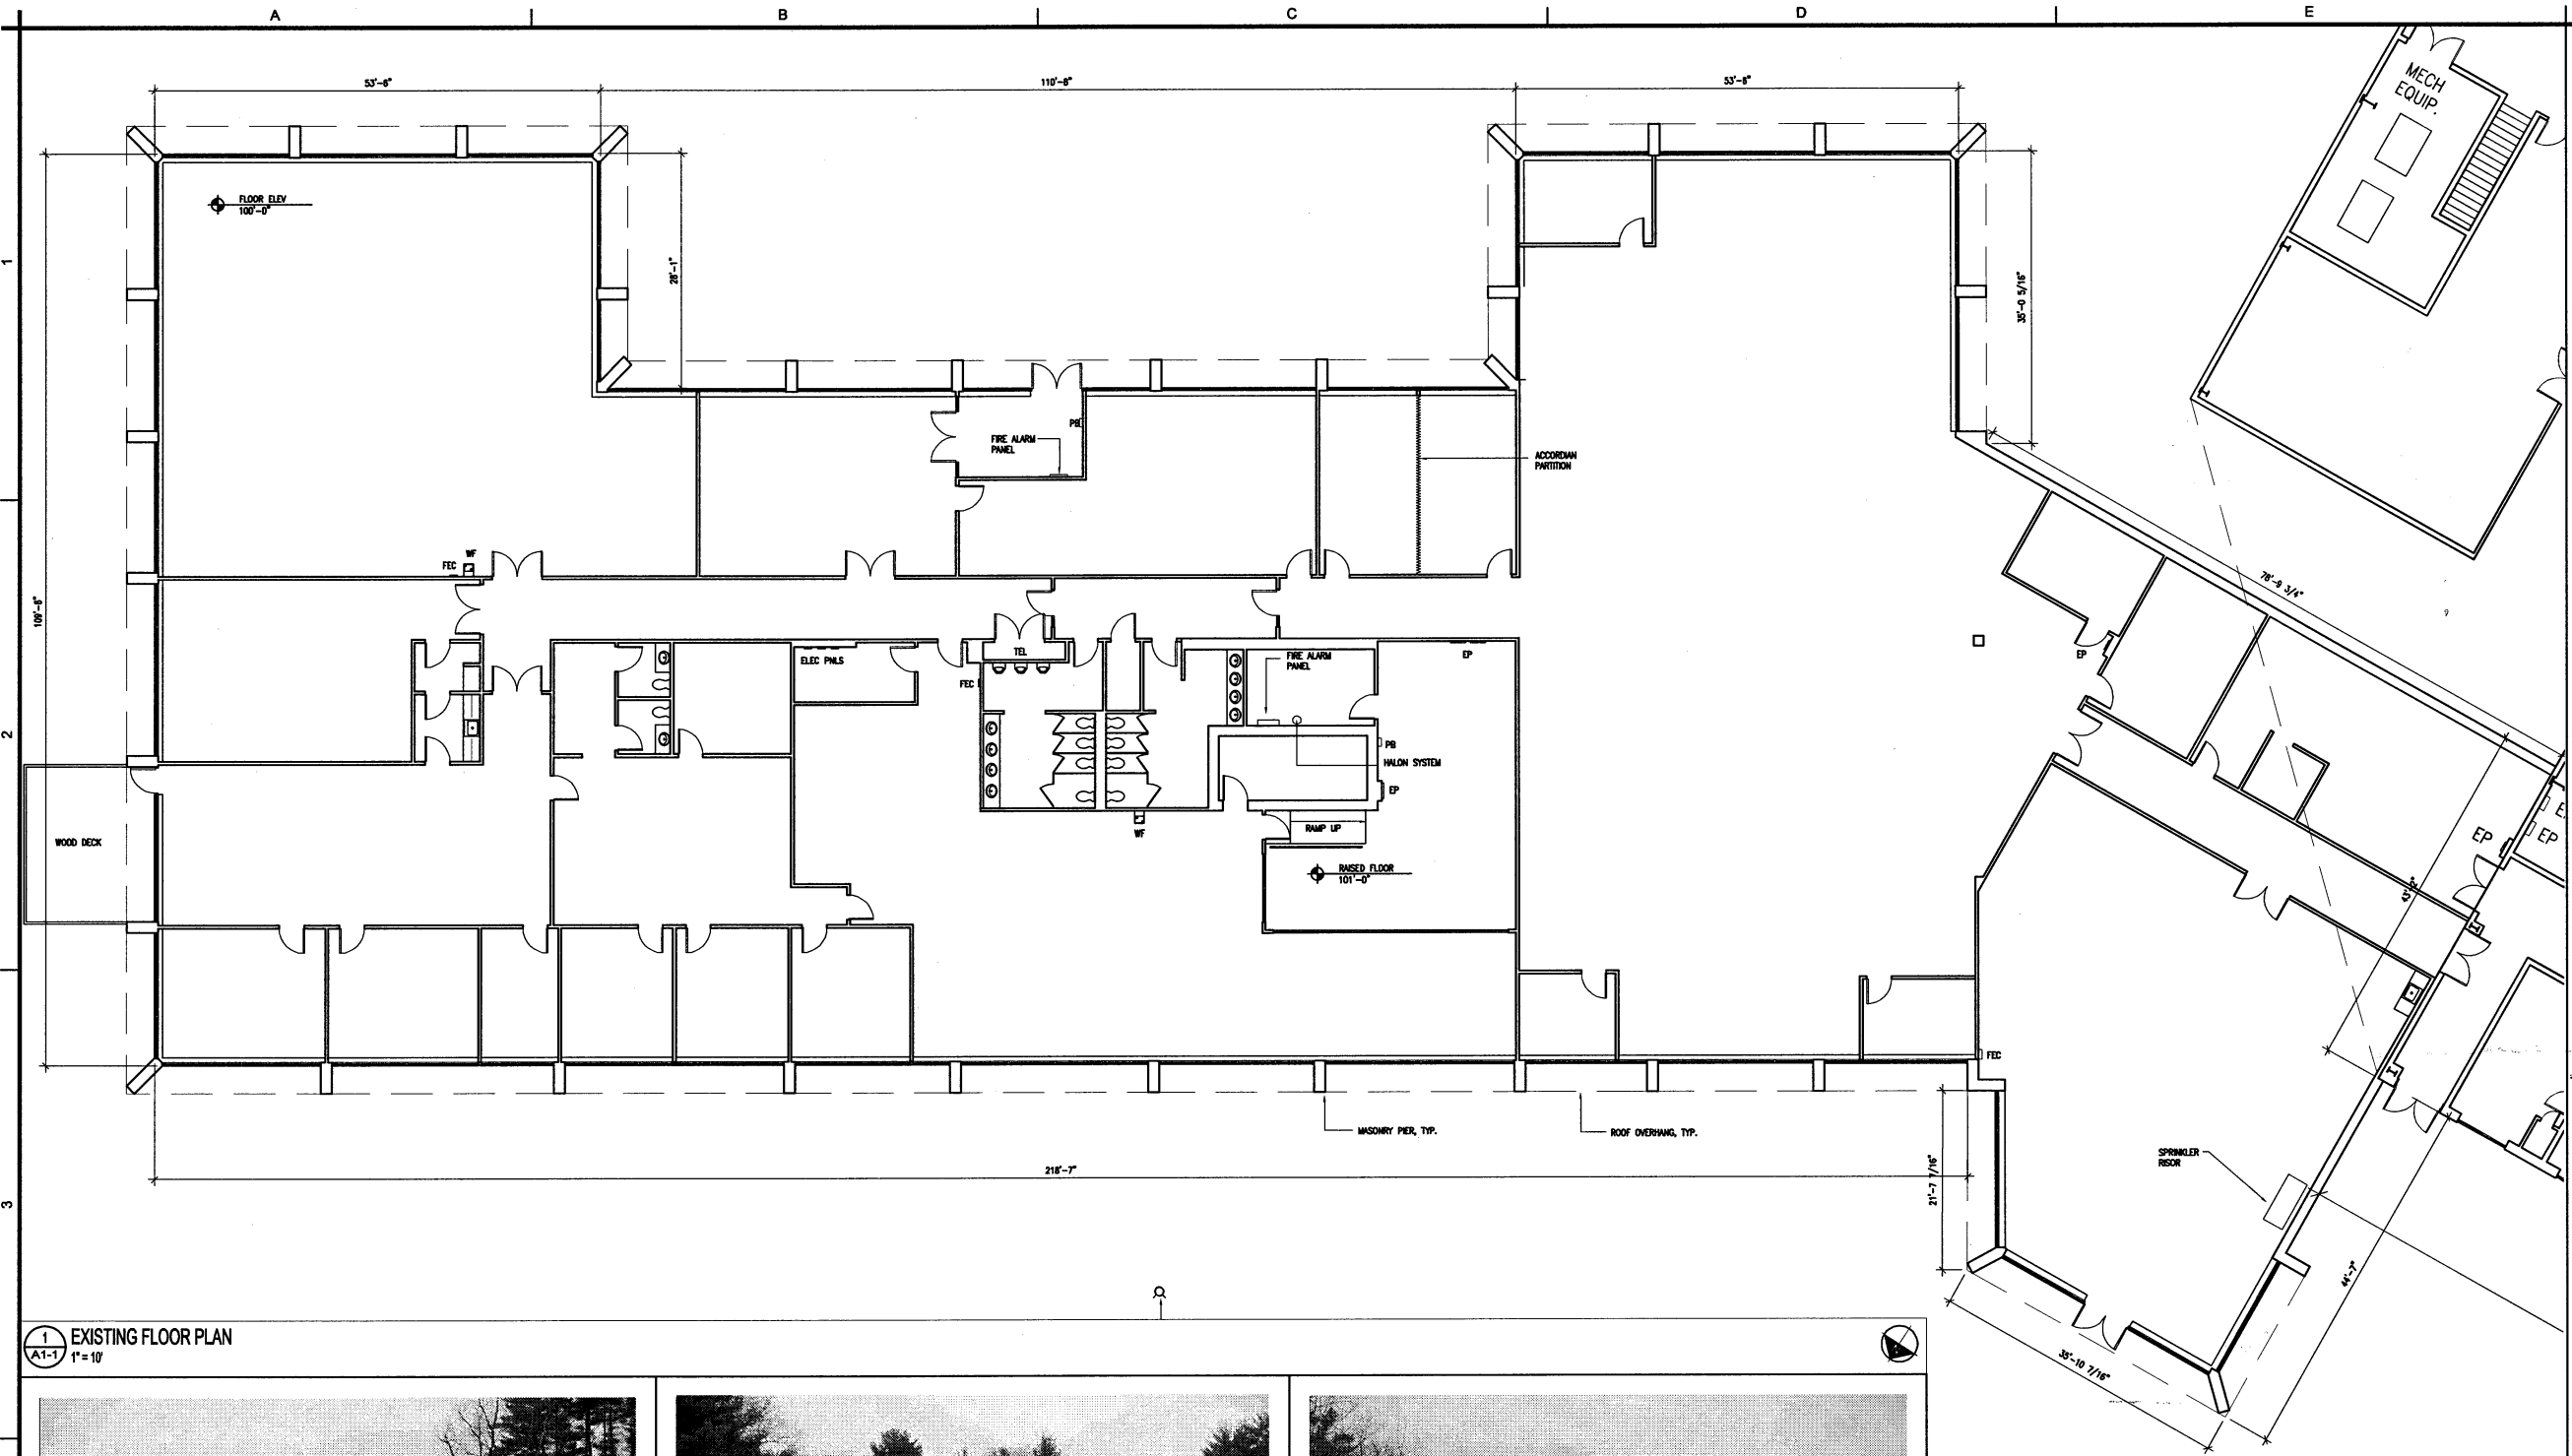

**WARRENSTREET ARCHITECTS**  
27 Warren Street Concord NH 03301  
1.603.225.0640 F.603.225.3621 www.warrenstreetarchitects.com

CONSULTANTS / KEY PLAN

PROJECT TITLE / ADDRESS

266 ROUTE 125  
KINGSTON, NH

SCALE: AS NOTED DWG: 2527A01-01  
JOB #: 2527 JREF: 2531REFP  
DWN BY: MRB CKD BY: JH  
04/30/04


EXISTING CONDITIONS  
NOT FOR CONSTRUCTION  
REVISIONS

EXISTING  
CONDITIONS  
DOCUMENTATION

**A1-2**

SHEET NUMBER OF  
Copyright Warrenstreet Architects © 2004


1 EXISTING FLOOR PLAN  
A1-1 1" = 1/8"

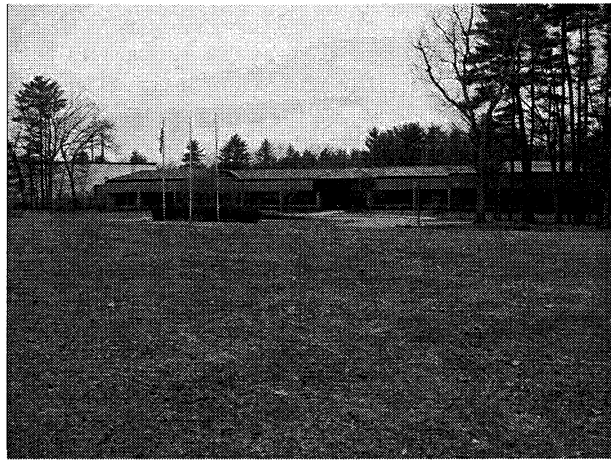


2 PHOTO  
A1-2



3 PHOTO  
A1-2

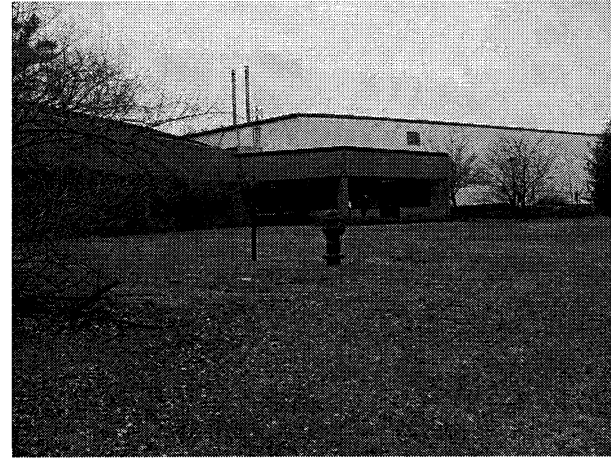

4 PHOTO  
A1-2

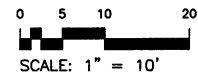

**WARRENSTREET ARCHITECTS**  
 27 Warren Street Concord NH 03301  
 T 603.225.0640 F 603.225.0621 www.warrenstreetarchitects.com

CONSULTANTS / KEY PLAN

PROJECT TITLE / ADDRESS

266 ROUTE 125  
 KINGSTON, NH

SCALE: AS NOTED DWG: 2527A01-01  
 JOB #: 2527 XREF: 2528REFP  
 DWN BY: MPB CKD BY: JH  
 04/30/04

EXISTING CONDITIONS  
 NOT FOR CONSTRUCTION  
 REVISIONS


EXISTING  
 CONDITIONS  
 DOCUMENTATION

**A1-1**

SHEET NUMBER OF  
 Copyright Warrenstreet Architects © 2004



1 PHOTO  
 A1-1

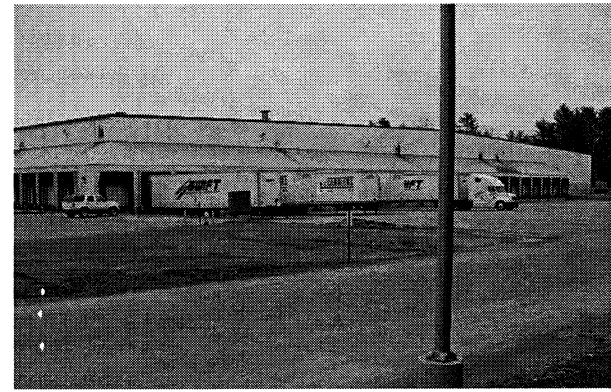


2 PHOTO  
 A1-1




3 PHOTO  
 A1-1



4 PHOTO  
 A1-1

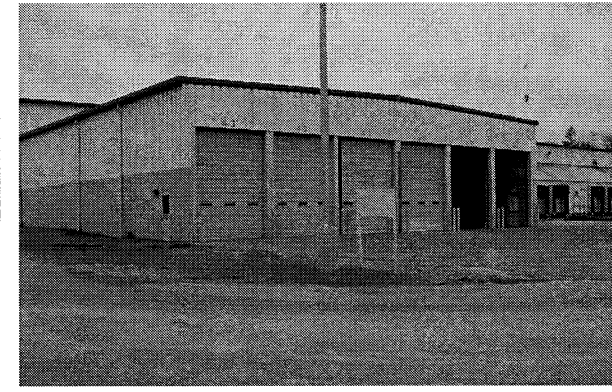


6 PHOTO  
 A1-1

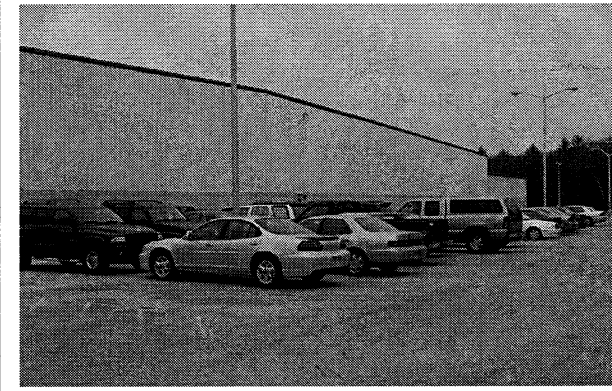

7 PHOTO  
 A1-1



8 PHOTO  
 A1-1

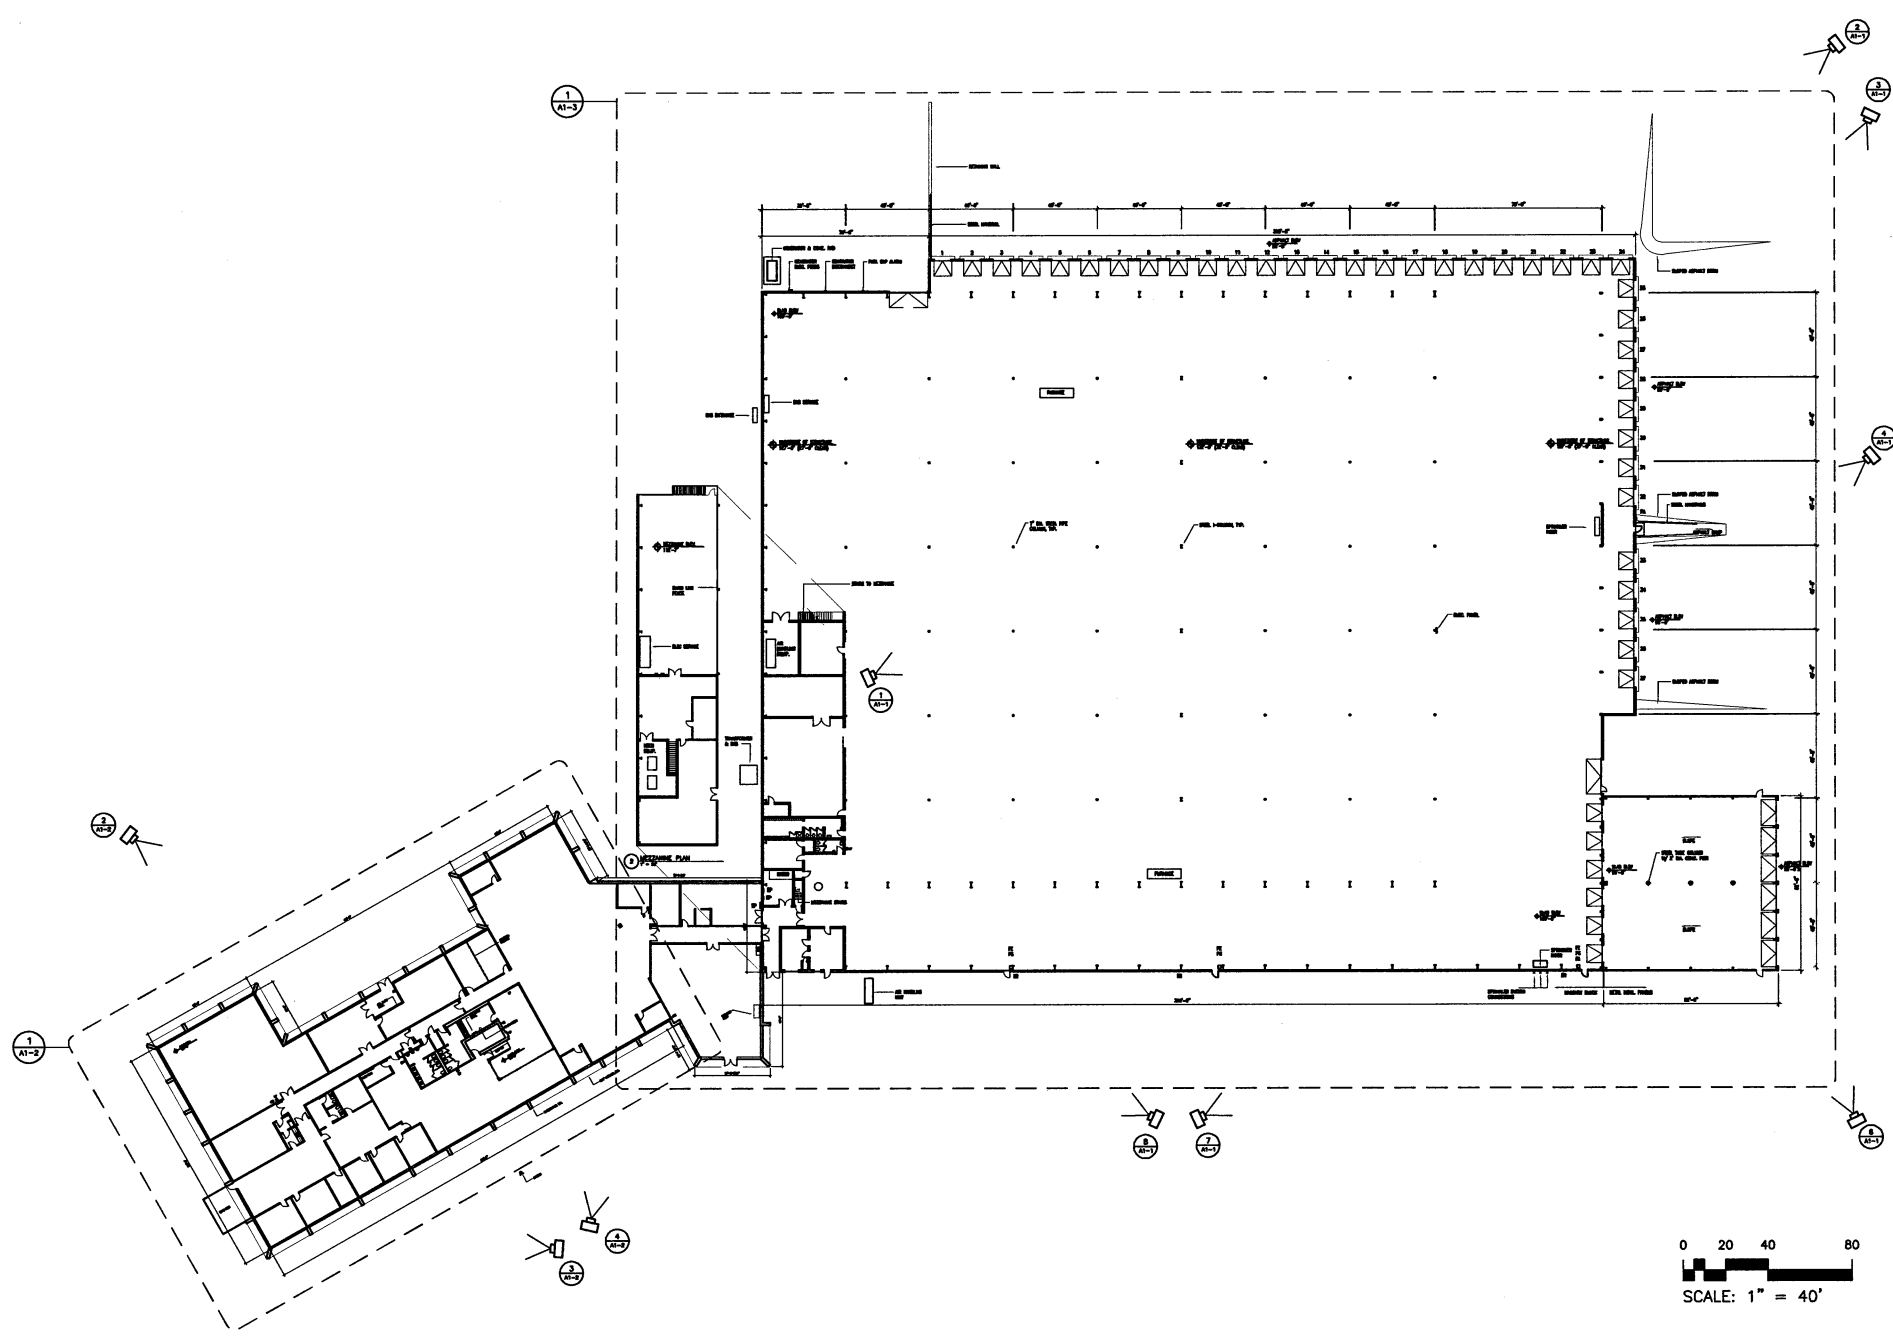

5 KEY PLAN  
 A1-1  
 1" = 40'

P:\PROJECTS\2531 SLS\Arch\2531A01-01.dwg, 4/30/2004 1:09:07 PM, mbernard, Acrobat PDFWriter, Custom page size